



NOTES:  
 \* Levels and Features shown on this plan are current at the time of survey and do not reflect any subsequent work undertaken by the Contractor or others.  
 \* Backfilled service locations provided by Contractor.  
 \* Selected entities dimensioned off future boundaries for clarity. These boundaries are subject to change.  
 \* Existing structures constructed in previous subdivisions have been depicted in a similar manner to subject structures by request of the relevant Council.

We Brazier Mottl Pty Ltd (ACN 066 411 041) hereby certify that the locations, surface and invert levels of all works and infrastructure presented on this drawing & relevant digital data set have been surveyed and meet the accuracy standards as defined within the FNQROC Development Manual, unless indicated otherwise.

..... Director  
 Date.....



braziermottl.com.au  
 SURVEYING  
 TOWN PLANNING  
 PROJECT MANAGEMENT  
 MAPPING & GIS

Brazier Mottl Pty Ltd (ABN 58 066 411 041)  
 Cairns - Ground Floor, Woree Plaza, 12-20 Toogood Road, Woree  
 Postal Address: PO Box 1185, Cairns, QLD 4870  
 Phone: 07 4033 2377 Fax: 07 4033 2399  
 email: caims@braziermottl.com.au

TOWNSVILLE BURDEKIN  
 Ph: 07 4752 1144 Ph: 07 4763 2166  
 Fax: 07 4772 2587 Fax: 07 4763 2480

Origin of Levels	PSM 75099
RL of Origin	RL = 51.802 AHD Der
Origin of Coord	PSM 75099
Coord of Origin	E 364794.137 N 8125238.393
Data Source File	34370-008-01.dwg
Surveyed	
Map Reference	
Approved	

REVISIONS				
No.	Date	Details	By	Check
1	05/05/20	Original Issue	MJM	

Client  
**URBEX 112 PTY LTD**

Project  
**AS CONSTRUCTED SURVEY OF POTABLE WATER RETICULATION  
 THE ENCLAVE LOTS 24-27 & 59  
 JACAMUNDA CIRCUIT - EARLVILLE**

Parish of  
 County of

Local Authority Cairns Regional Council Original Portion Orig Por Meridian M.G.A. Zn 55

Date	5th May, 2020
Scale	1:500
Job No	34370/008-02
Sheet 1 of 1	
Drawing No.	<b>34370/091</b>
Revision No.	(1)



- NOTES:**
- \* Manholes are located at the centre of the manhole chamber.
  - \* Grades of pipes are calculated between chamber setout points, using invert levels to the nearest whole centimetre, at the request of the relevant Council.
  - \* Invert Levels of pipes are measured where the pipe enters the manhole.
  - \* Levels and Features shown on this plan are current at the time of survey and do not reflect any subsequent work undertaken by the Contractor.
  - \* PCB invert levels recorded at connection to main sewer line by request of the relevant Council.
  - \* Endcap/PCB positions and Endcap invert levels supplied by Contractor.
  - \* Selected entities dimensioned off future boundaries for clarity. These boundaries are subject to change.
  - \* Existing structures constructed in previous subdivisions have been depicted in a similar manner to subject structures by request of the relevant Council.

We Brazier Mottl Pty Ltd (ACN 066 411 041) hereby certify that the locations, surface and invert levels of all works and infrastructure presented on this drawing & relevant digital data set have been surveyed and meet the accuracy standards as defined within the FNQROC Development Manual, unless indicated otherwise.

..... Director

Date.....



braziermottl.com.au

**SURVEYING  
TOWN PLANNING  
PROJECT MANAGEMENT  
MAPPING & GIS**

Brazier Mottl Pty Ltd (ABN 58 066 411 041)  
 Cairns - Ground Floor, Woree Plaza, 12-20 Toogood Road, Woree  
 Postal Address: PO Box 1185, Cairns, QLD 4870  
 Phone: 07 4033 2377 Fax: 07 4033 2399  
 email: caims@braziermottl.com.au

TOWNSVILLE BURDEKIN  
 Ph: 07 4752 1144 Ph: 07 4752 3766  
 Fax: 07 4752 2587 Fax: 07 4753 2460

Origin of Levels	PSM 75099
RL of Origin	RL = 51.802 AHD Der
Origin of Coord	PSM 75099
Coord of Origin	E 364794.137 N 8125238.393
Data Source File	34370-008-01.dwg
Surveyed	
Map Reference	
Approved	

REVISIONS					
No.	Date	Details	By	Check	
1	05/05/20	Original Issue			

Client **URBEX 112 PTY LTD**

Project **AS CONSTRUCTED SURVEY OF SEWER RETICULATION  
THE ENCLAVE LOTS 24-27 & 59  
JACAMUNDA CIRCUIT - EARLVILLE**

Parish of \_\_\_\_\_ County of \_\_\_\_\_

Local Authority Cairns Regional Council Original Portion Orig Por Meridian M.G.A. Zn.55

Date	5th May, 2020
Scale	1:500 @ A1
Job No	34370/008-02
Sheet 1 of 1	
Drawing No.	<b>34370/092</b> (1)




NOTES:  
 \* Invert levels of pipes are taken where the pipe enters the pit.  
 \* Length of pipes is calculated between chamber setout points (varies by type).  
 \* Levels and Features shown on this plan are current at the time of survey and do not reflect any subsequent work undertaken by the Contractor.  
 \* Existing structures constructed in previous subdivisions have been depicted in a similar manner to subject structures by request of the relevant Council.

We Brazier Moti Pty Ltd (ACN 066 411 041) hereby certify that the locations, surface and invert levels of all works and infrastructure presented on this drawing & relevant digital data set have been surveyed and meet the accuracy standards as defined within the FNQROC Development Manual, unless indicated otherwise.

..... Director

Date.....

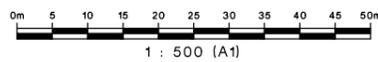

braziermotti.com.au

**SURVEYING**  
**TOWN PLANNING**  
**PROJECT MANAGEMENT**  
**MAPPING & GIS**

Brazier Moti Pty Ltd (ABN 58 066 411 041)  
 Cairns - Ground Floor, Woree Plaza, 12-20 Toogood Road, Woree  
 Postal Address: PO Box 1185, Cairns, QLD 4870  
 Phone: 07 4033 2377 Fax: 07 4033 2399  
 email: cairns@braziermotti.com.au

TOWNSVILLE BURDEKIN  
 Ph: 07 4752 1144 Ph: 07 4783 3766  
 Fax: 07 4772 2587 Fax: 07 4783 2460

Origin of Levels	PSM 75099
RL of Origin	RL = 51.802 AHD Der
Origin of Coord	PSM 75099
Coord of Origin	E 364794.137 N 8125238.393
Data Source File	34370-008-01.dwg
Surveyed	
Map Reference	
Approved	


REVISIONS				
No.	Date	Details	By	Check
1	05/05/20	Original Issue	MJM	

Client **URBEX 112 PTY LTD**

Project **AS CONSTRUCTED SURVEY OF STORMWATER RETICULATION**  
**THE ENCLAVE LOTS 24-27 & 59**  
**JACAMUNDA CIRCUIT - EARLVILLE**

Parish of \_\_\_\_\_ County of \_\_\_\_\_  
 Local Authority Cairns Regional Council Original Portion Orig Por Meridian M.G.A. Zn 55

Date	5th May, 2020
Scale	1:500 @ A1
Job No	34370/008-02
Sheet	1 of 1
Drawing No.	<b>34370/093</b> (1)

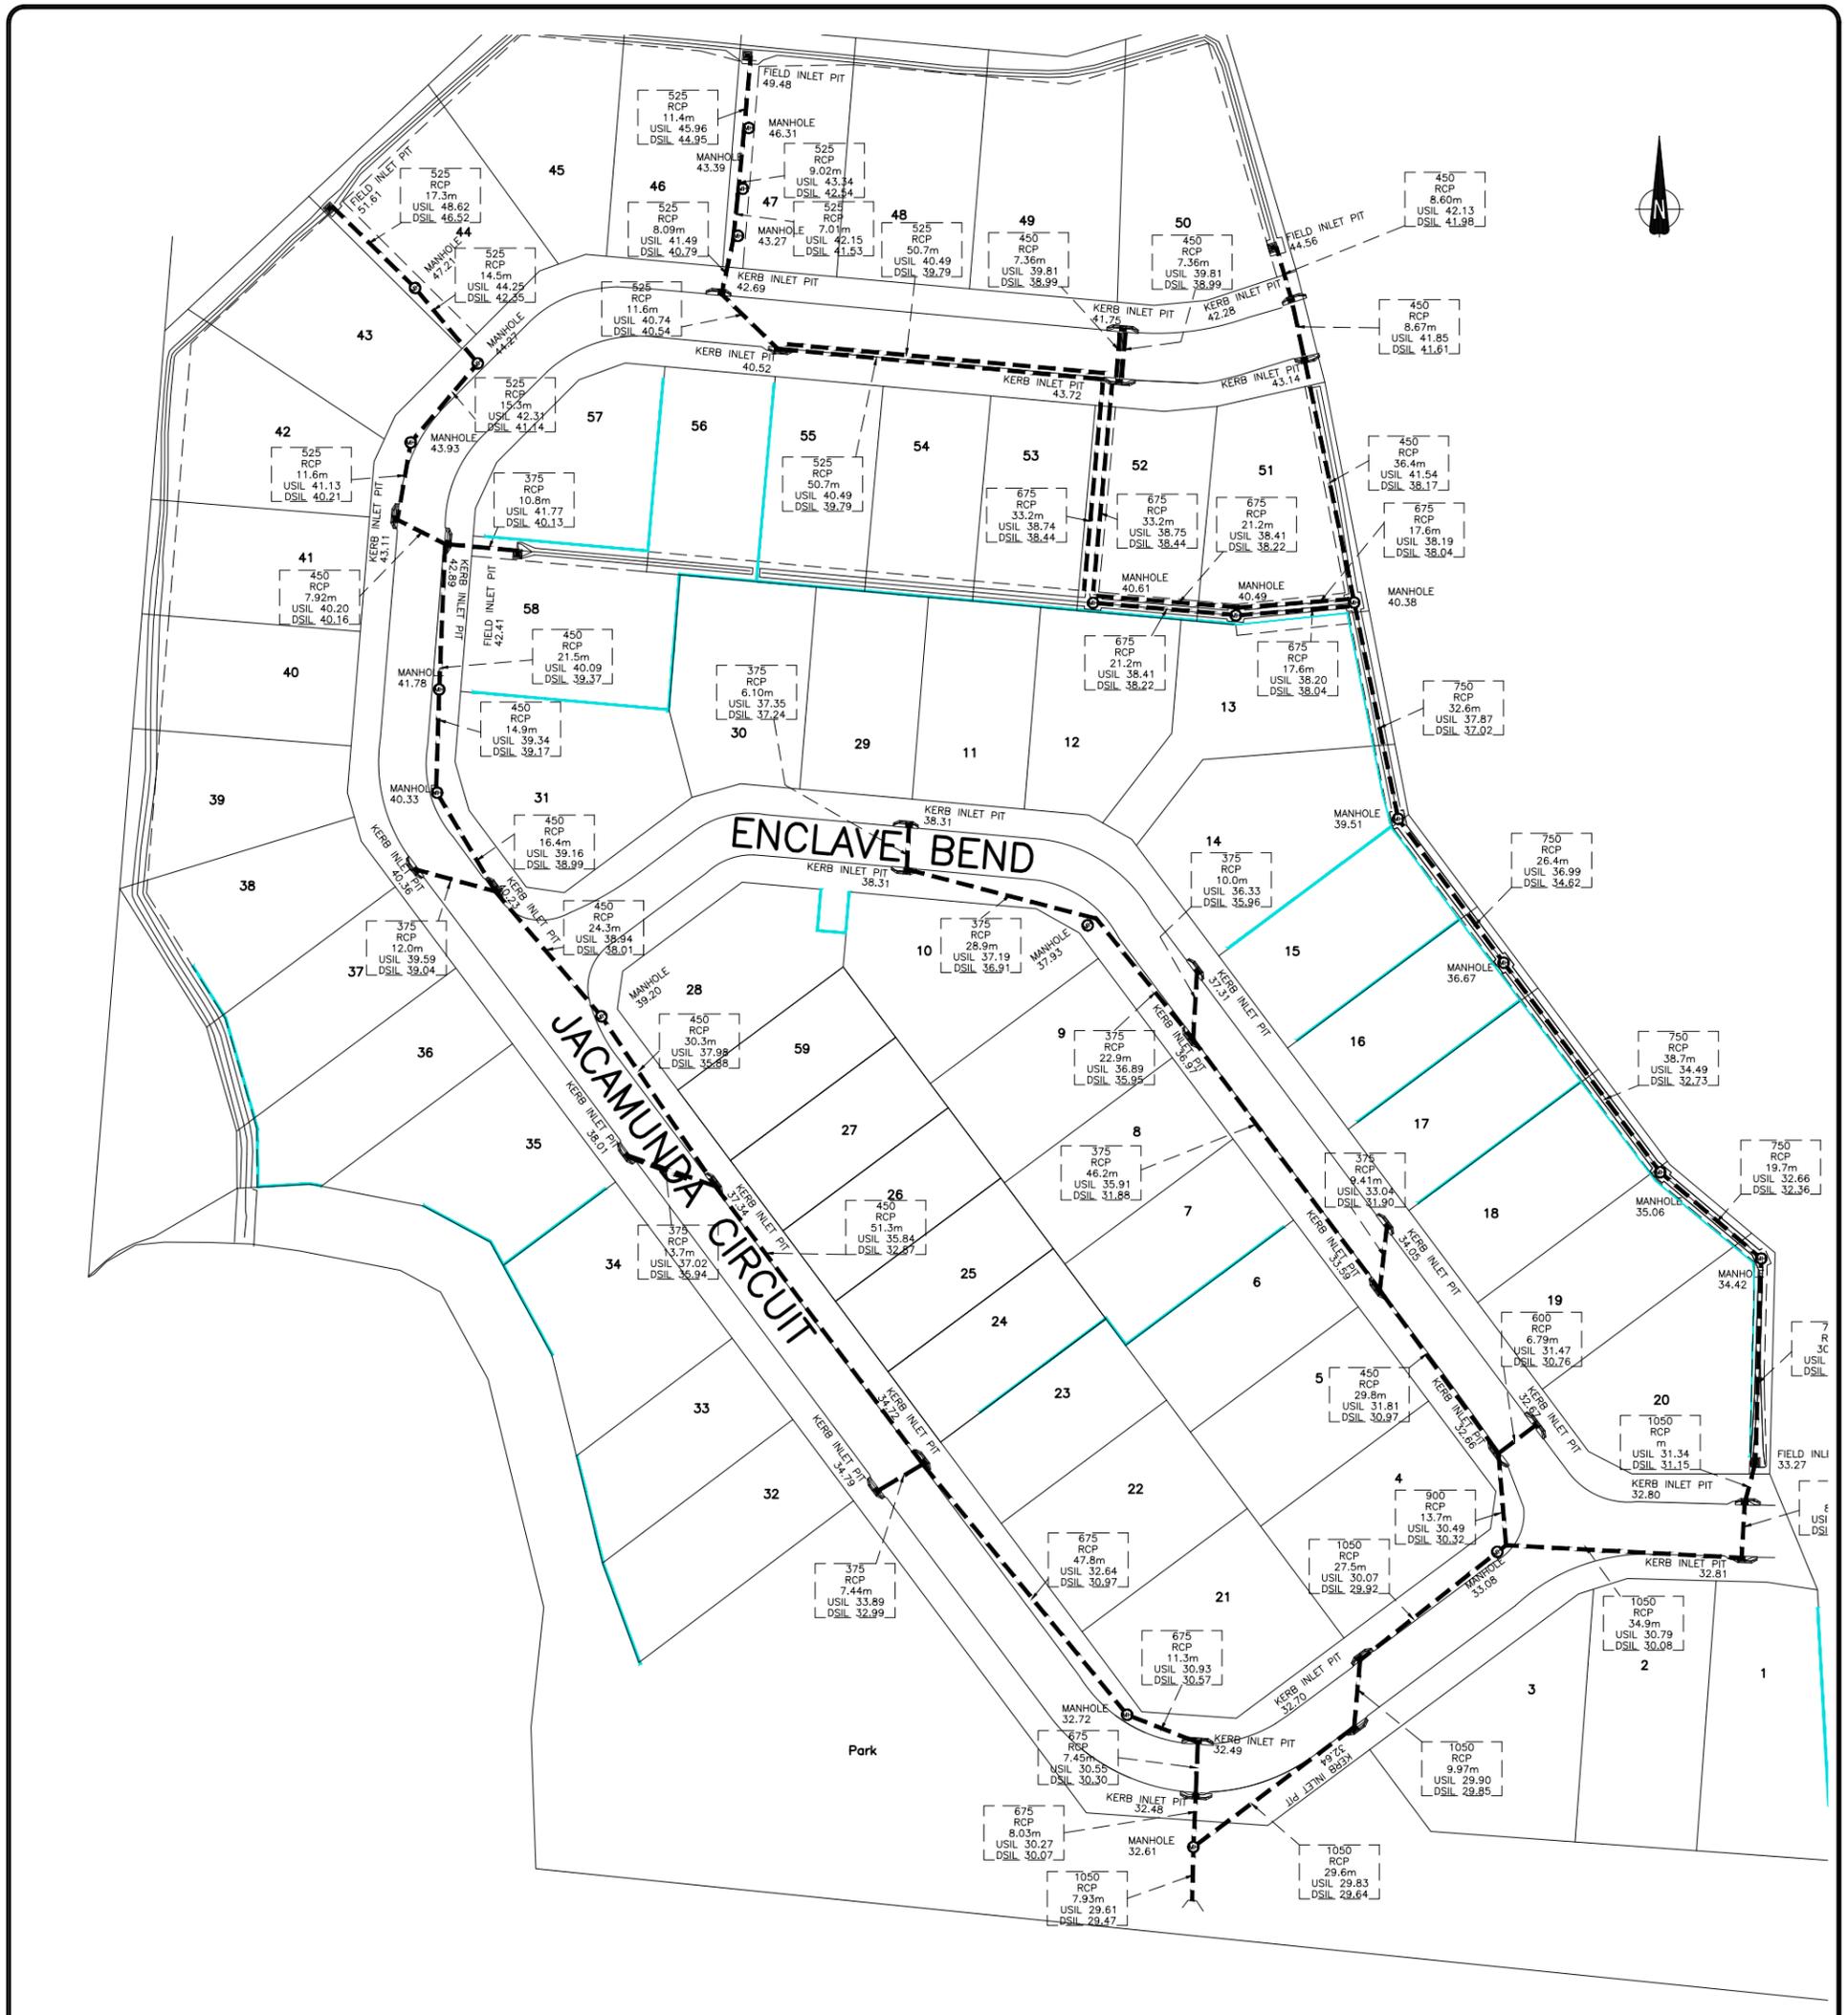

**NOTES:**  
 \* Invert levels of pipes are taken where the pipe enters the pit.  
 \* Length of pipes is calculated between chamber setout points (varies by type).  
 \* Levels and Features shown on this plan are current at the time of survey and do not reflect any subsequent work undertaken by the Contractor.  
 \* Existing structures constructed in previous subdivisions have been depicted in a similar manner to subject structures by request of the relevant Council.

We Brazier Moti Pty Ltd (ACN 066 411 041) hereby certify that the locations, surface and invert levels of all works and infrastructure presented on this drawing & relevant digital data set have been surveyed and meet the accuracy standards as defined within the FNQROC Development Manual, unless indicated otherwise.

..... Director  
 Date.....



braziermotti.com.au

**Surveying**  
**Town Planning**  
**Project Management**  
**Mapping & GIS**

Brazier Moti Pty Ltd (ABN 58 066 411 041)  
 Cairns - Ground Floor, Woree Plaza, 12-20 Toogood Road, Woree  
 Postal Address: PO Box 1185, Cairns, QLD 4870  
 Phone: 07 4033 2377 Fax: 07 4033 2399  
 email: caims@braziermotti.com.au

TOWNSVILLE BURDEKIN  
 Ph: 07 4752 1144 Ph: 07 4783 3766  
 Fax: 07 4772 2587 Fax: 07 4783 2460

Origin of Levels	PSM 75099
RL of Origin	RL = 51.802 AHD Der
Origin of Coord	PSM 75099
Coord of Origin	E 364794.137 N 8125238.393
Data Source File	34370-008-01.dwg
Surveyed	
Map Reference	
Approved	

REVISIONS				
No.	Date	Details	By	Check
1	05/05/20	Original Issue		

Client **URBEX 112 PTY LTD**

Project **AS CONSTRUCTED SURVEY OF STORMWATER RETICULATION THE ENCLAVE LOTS 24-27 & 59 JACAMUNDA CIRCUIT - EARLVILLE**

Parish of \_\_\_\_\_ County of \_\_\_\_\_

Local Authority Cairns Regional Council Original Portion Orig Por Meridian M.G.A. Zn 55

Date	5th May, 2020
Scale	1:500 @ A1
Job No	34370/008-02
Sheet 1 of 1	
Drawing No.	<b>34370/093</b> (1)